



ISLAND COUNTY HEALTH DEPARTMENT

PO Box 5000 / 1 NE 6TH Street
Coupeville, WA 98239-5000

FAX COVER SHEET

TO: Pete of CB Koltje

FAX NUMBER: _____

TOTAL PAGES SENT: 3 (including cover sheet)

DATE: 9/10/15

FROM: Island County Health Department

FAX NUMBER: (360) 679-7390

PHONE NUMBER: (360) 679-7350

☐ Site Registration / Soil Logs

☒ Asbuilt

S 8420 - 00 - 00010 - 0

Comments / RE:

\$10.00 fee
for permit

ISLA COUNTY HEALTH DEPARTMENT
Post Office Box 218 - Coupeville, Washington

Phone 678-4008 4/10-71

APPLICATION FOR PERMIT TO CONSTRUCT A SEWAGE DISPOSAL SYSTEM

Applicant's name: Joaquin Blas
Mailing address: Rt 3 Bx 3355 Oak Harbor Phone: 675-6927
Location of construction site: N.E. corner of Elstad Rd & Wilson Rd.

Street number is out of Whidbey Park Div. #1 Distance to nearest cross road

Legal description: Lot 10 Sec. 19 Twp. 33 Blk. Rge. 2E Addition

Type of use Residential No. of bedrooms 2 No. of bathrooms 1

Lot width: 330 ft. Lot depth: 330 ft. 100,900 sq. ft.

Source of drinking water: Public supply ~~Private Well~~

1. Dig a hole at least 4 feet deep in the disposal field area. After the hole is dug record the soil conditions at the following depths:
(record as sand, gravel, clay, packed sand, loam, etc)

12 inches Grave 24 inches Gravel 36 inches Gravel 48 inches Gravel

2. Furnish sketch on reverse side hereof, or attach plot plan of premises showing -
- a. Distances between property lines and sewage system.
 - b. Distance to any well, spring, creek or other body of water.
 - c. Show direction and approximate slope of lot.
 - d. Show the location and layout of the septic tank system.
 - e. List size of septic tank, inside length, inside width, water depth capacity in gallons.
 - f. Width, length and depth of drain lines, amount of gravel under tile, amount of gravel over tile, type of tile used.
 - g. Location of buildings and driveways, swimming pools, etc.

3. Percolation test made ☒ Date 9/9 Result: 1 in/min

I hereby state that the information above and on the reverse side hereof, or attached hereto is correct and true to the best of my knowledge. I understand that the permit must be obtained before any construction is begun, either on the building or the sewage disposal system, and a satisfactory inspection of system is required before the sewage disposal system may be backfilled, or put to use.

Signed: Joaquin Blas (by; W.L. Massey) Date: 9/10/71
Owner

Signed: John Reentjes (by; W.L. Massey) Date: 9/10/71
Contractor

Plan approved: Permit No. 206-11 Receipt No. 3746 Date 9-10-71

Final inspection approved ☒ Rejected By: John Reentjes Date 9-20-71

Remarks:

Permit Expires One Year From Date Issued


410-71

Tank: Gallons Capacity 750 Tank MFG Everett Bros Combs

Field Total 95 Width 24" Depth 24" No. of lines 1 Sq Feet 170

Gravel: Size 1 1/2" Overtile 2 inches, Undertile 6 inches.

Wilson Rd

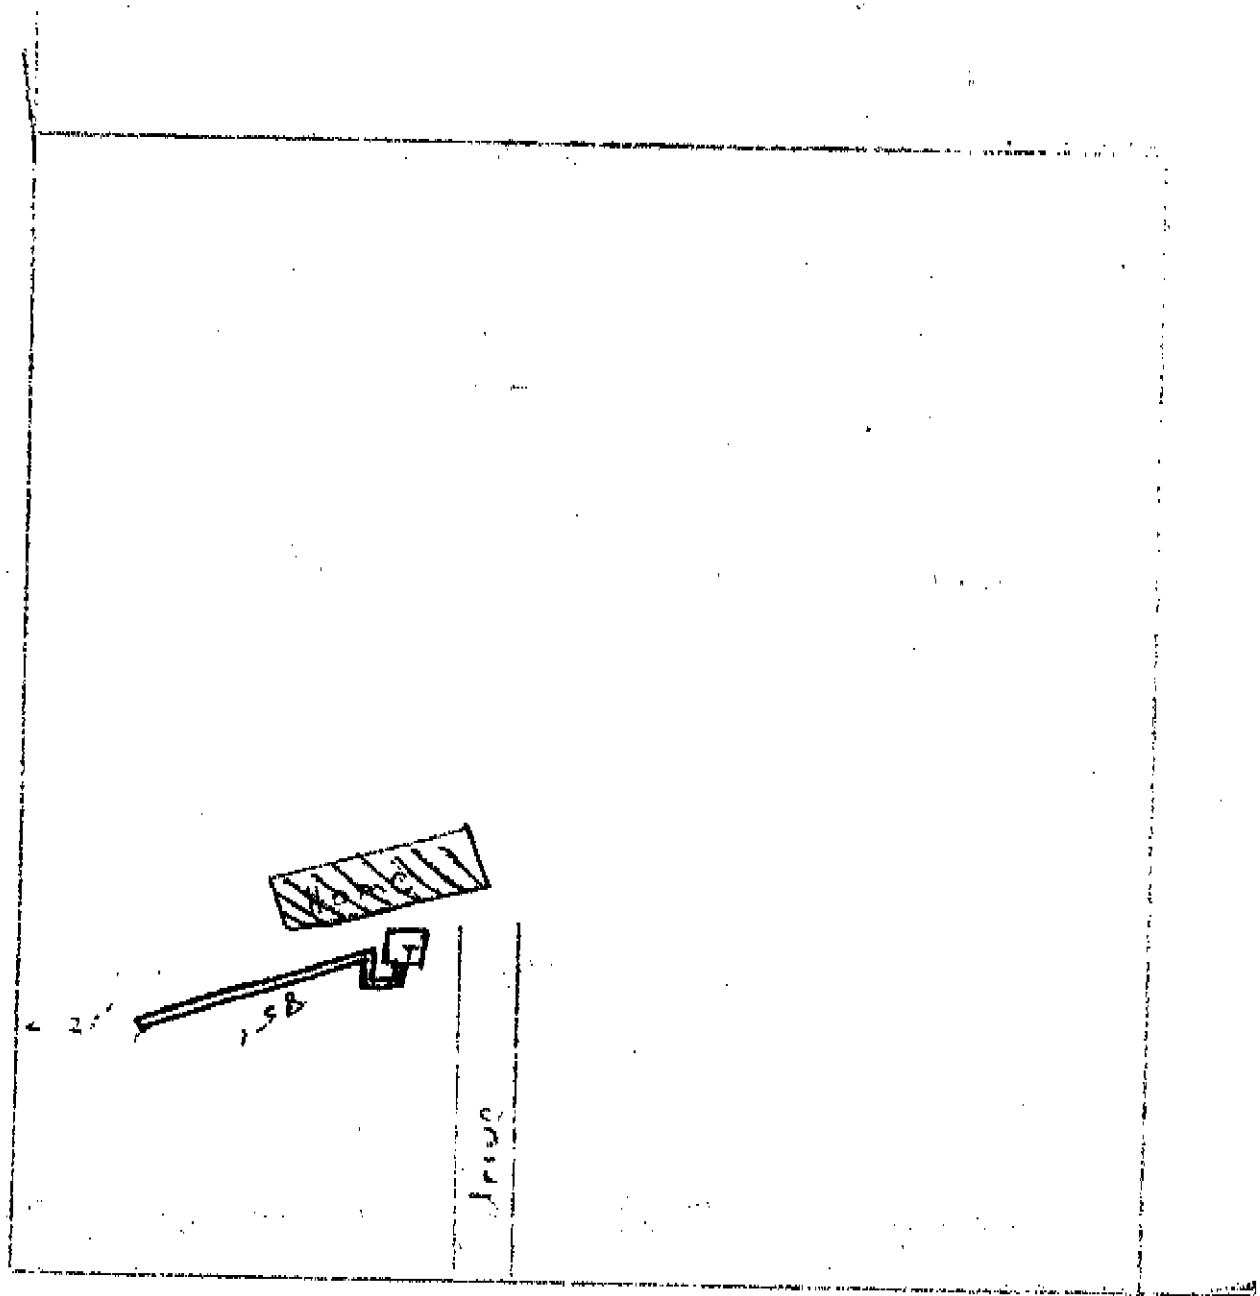

Elstad Rd